

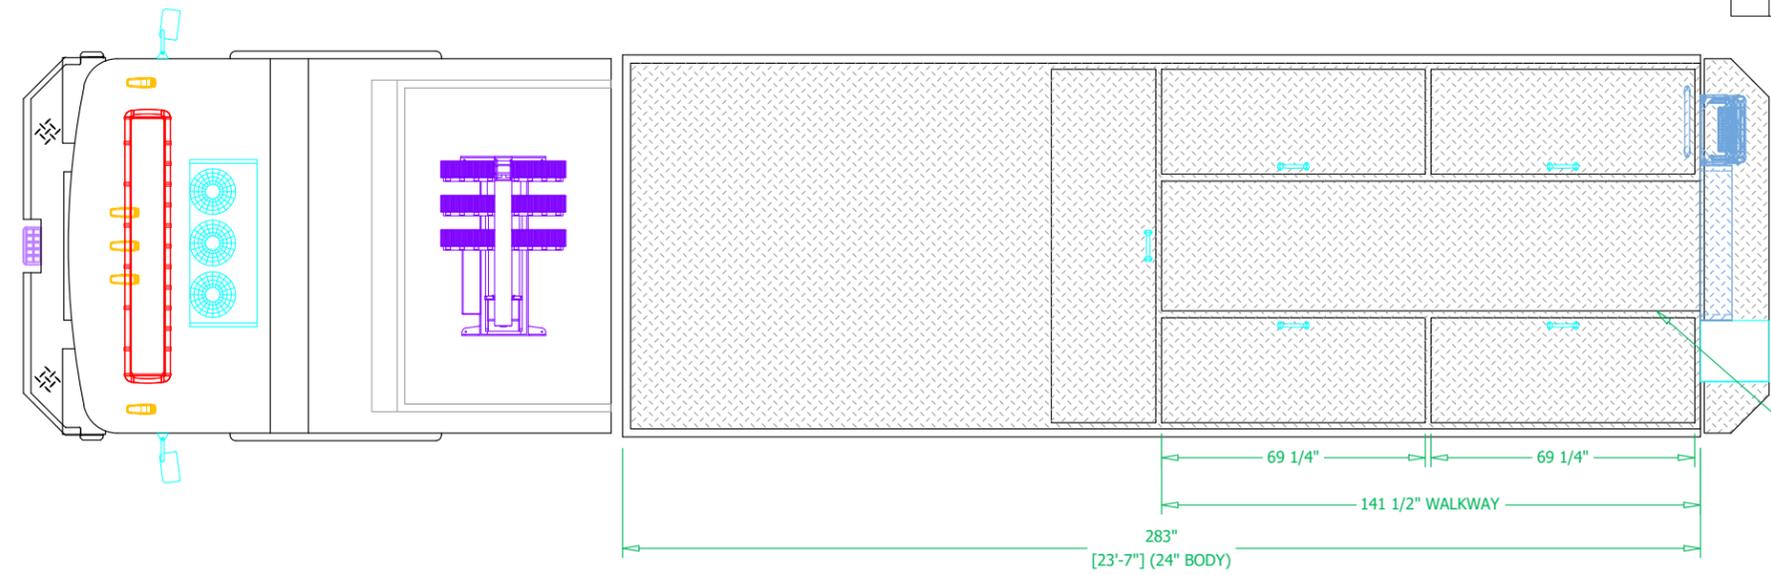


REVISIONS			
REV	DESCRIPTION	DATE	BY

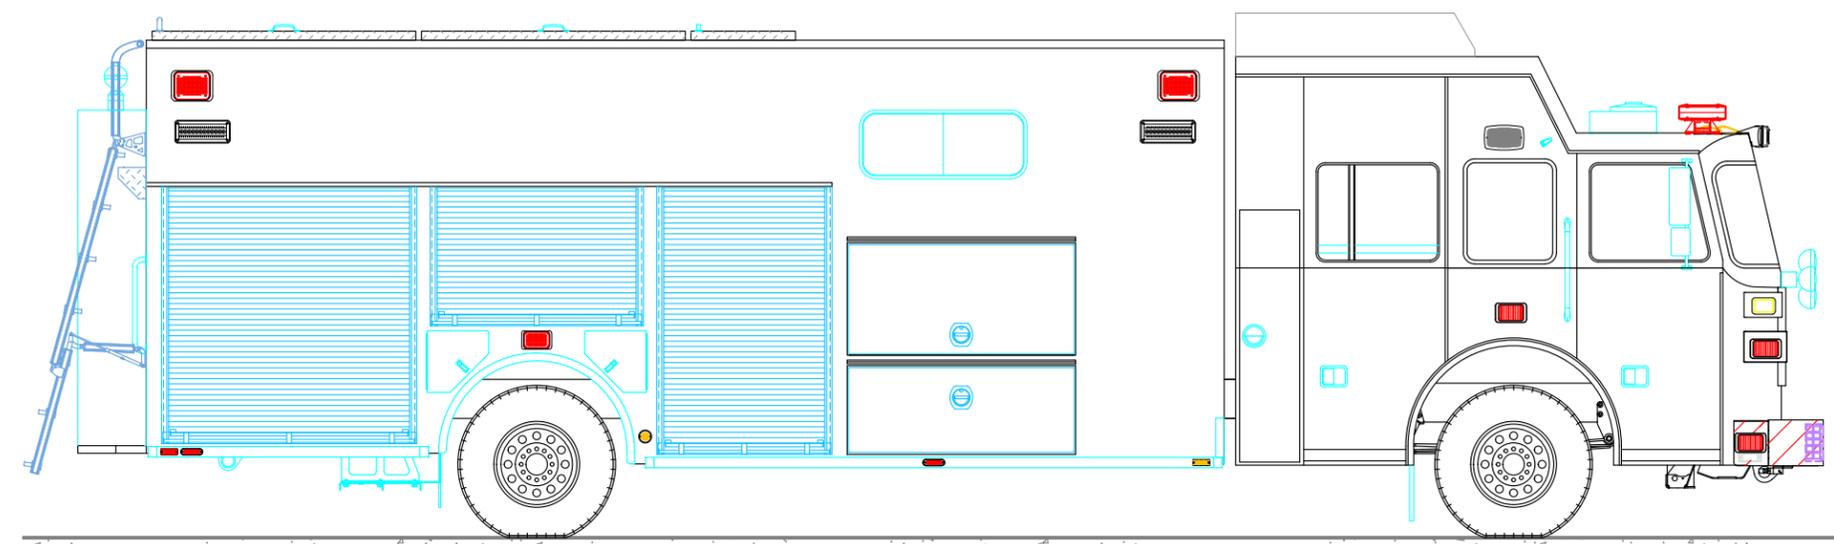

WEATHER STATION CONNECTION WITH PROTECTIVE BOX

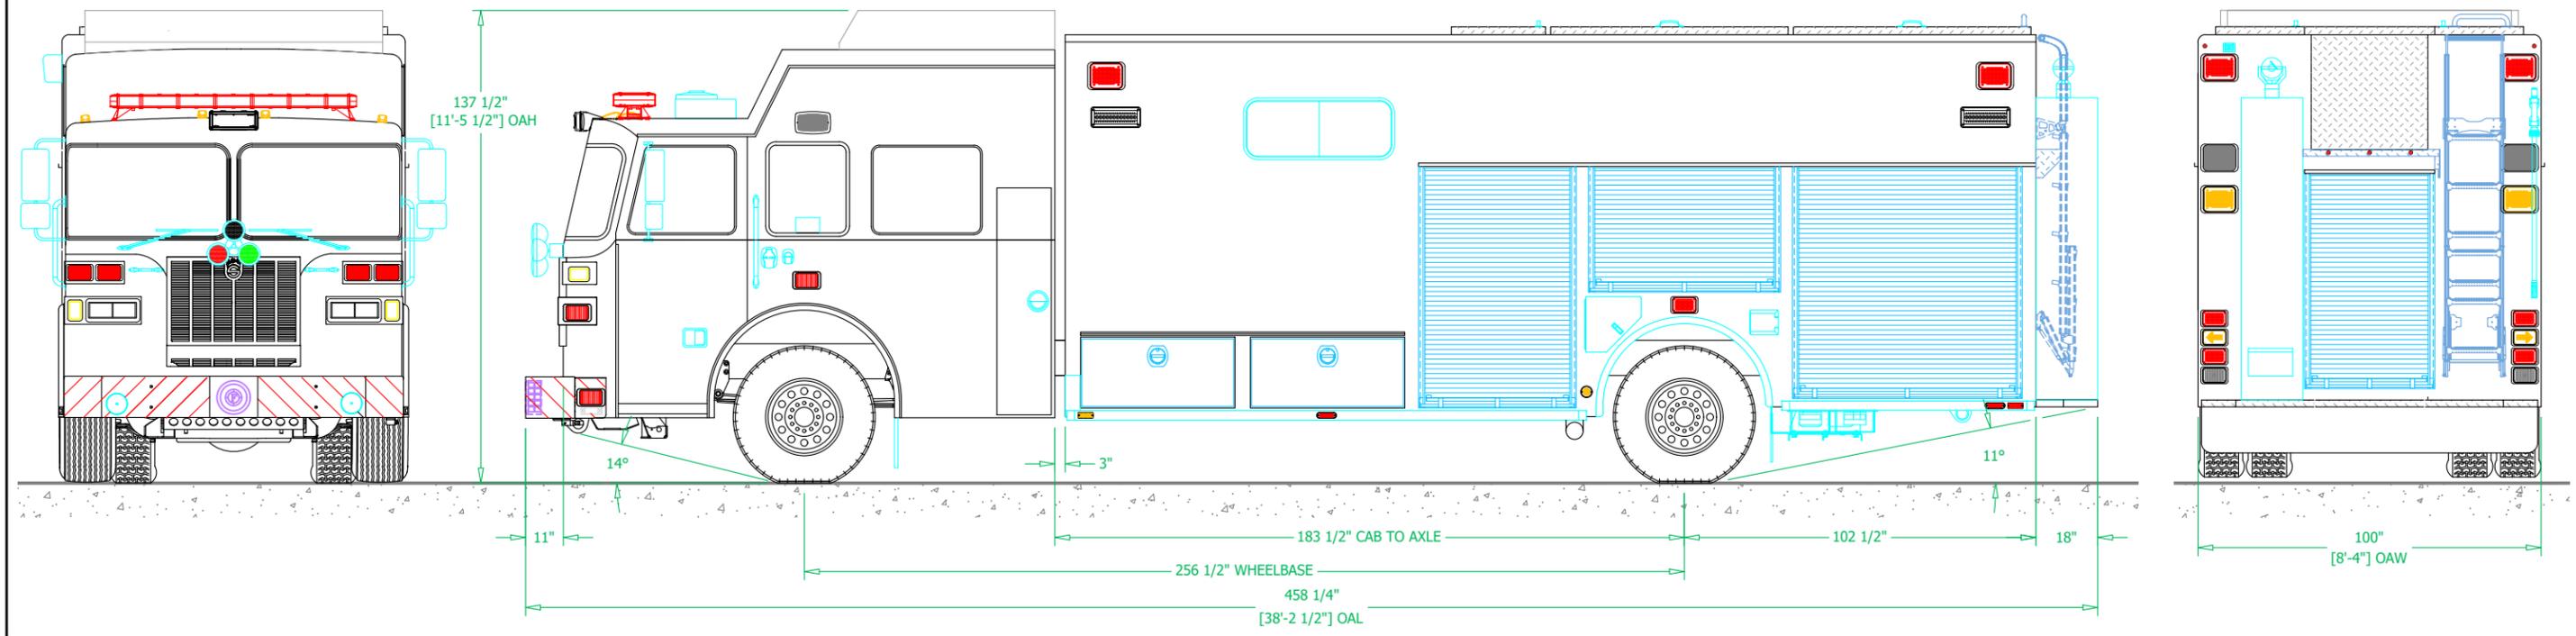

THIS PRINT IS PROVIDED ON A RESTRICTED BASIS AND IS NOT TO BE USED IN ANY WAY DETRIMENTAL TO THE INTEREST OF SUTPHEN CORPORATION.


SUTPHEN CORPORATION
 FIRE APPARATUS SINCE 1890
 7000 COLUMBUS-MARYSVILLE ROAD
 AMLIN, OHIO 43002

**LEXINGTON COUNTY
 FIRE SERVICE**


BODY SIZE: 24' BODY	UNIT TYPE: HAZ-MAT
BODY MATERIAL: 3/16" ALUMINUM	TRUCK NO: SVI #1209
CHASSIS TYPE: SUTPHEN	WHEELBASE: 256.5"
56"	CAB TO AXLE: 183.5"
20" RR	OVERALL LENGTH (OAL): 458.5"
FOUR DOOR	OVERALL WIDTH (OAW): 100"
	OVERALL HEIGHT (OAH): 138"

DRAWN BY: KP DATE: March 20, 2023 SCALE: 1/4" = 1'-0"
 DRAWING NO: LexingtonCounty SC hz24 AsBuilt SHEET 1 OF 3


REVISIONS			
REV	DESCRIPTION	DATE	BY

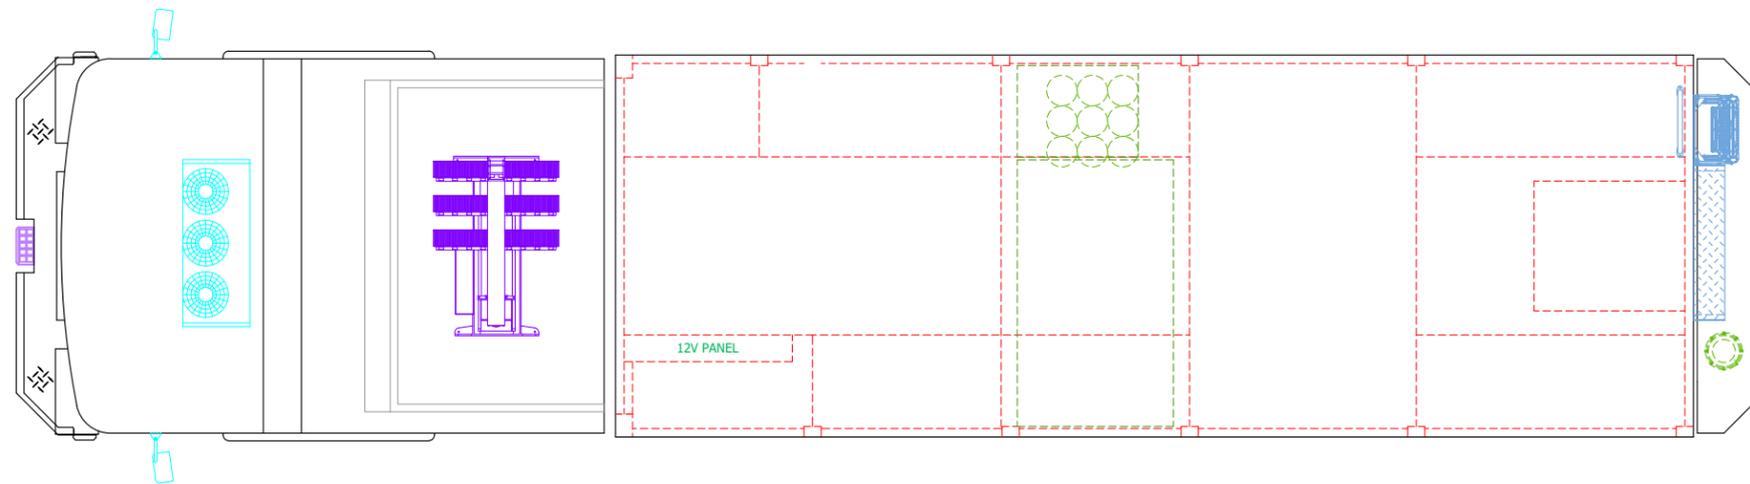


- CL KNIGHT LIGHT 415A-CH (6-LEDS) LIGHT TOWER
- TWO (2) WHELEN 900 SCENE - CHROME ONE (1) EACH SIDE
- EIGHT (8) WHELEN 600 RED LED - CHROME FOUR (4) EACH SIDE

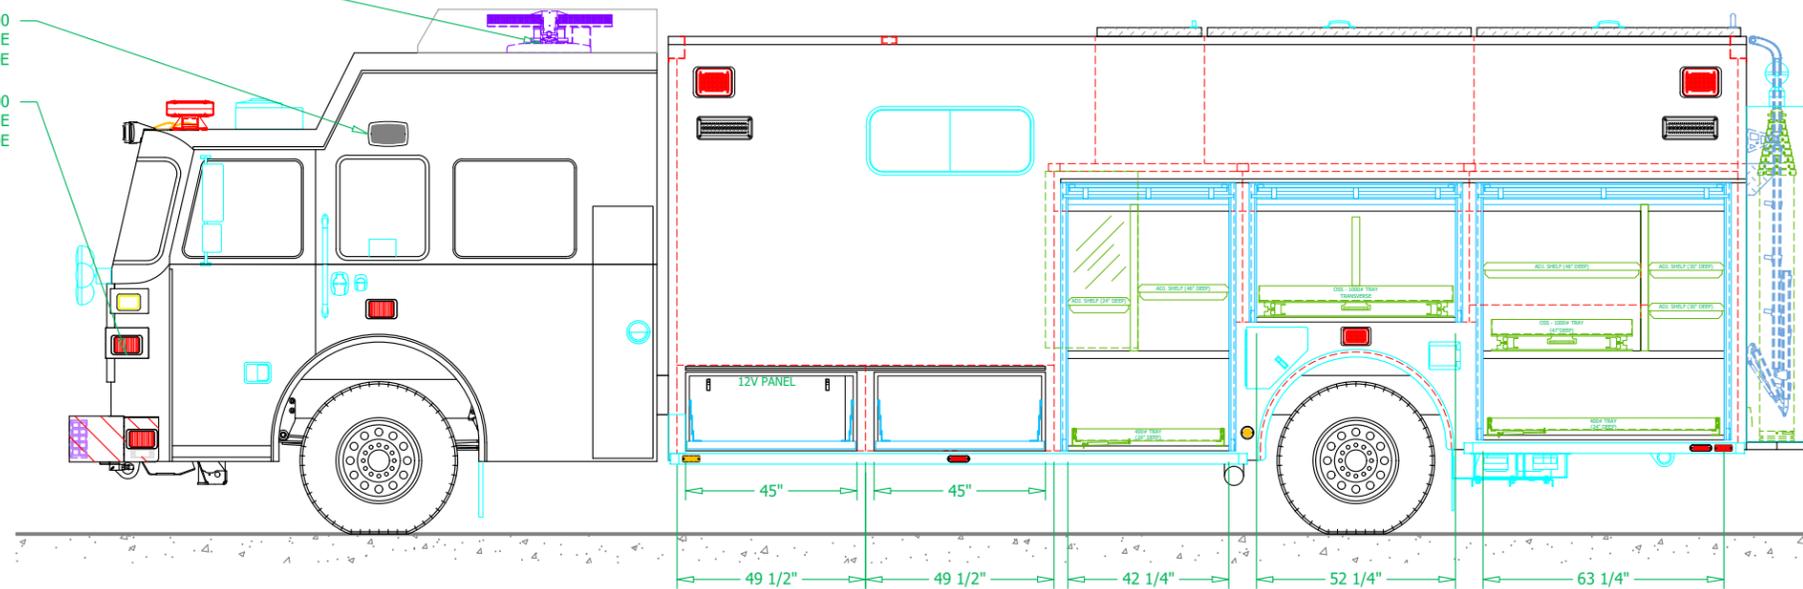

- TWO (2) WHELEN 900 RED LED - CHROME
- TWO (2) WHELEN 900 SCENE - CHROME
- TWO (2) WHELEN 900 AMBER LED - CHROME
- TWO (2) WHELEN 600 RED LED - WARNING
- TWO (2) WHELEN 600 AMBER LED - TURN
- TWO (2) WHELEN 600 RED LED - BRAKE
- TWO (2) WHELEN 600 CLEAR LED - BACK-UP

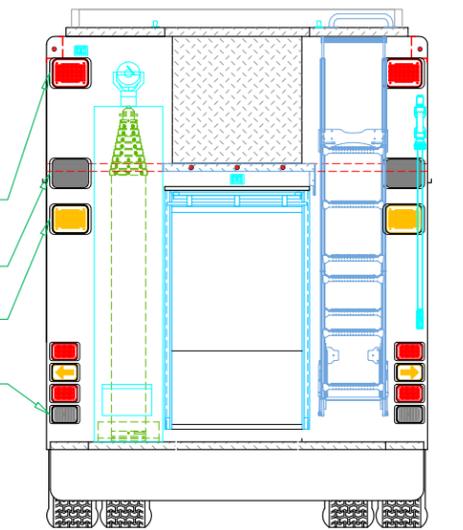

- FOUR (4) WHELEN 900 RED LED - CHROME TWO (2) EACH SIDE
- FOUR (4) FRC SPECTRA MAX SCENE - CHROME TWO (2) EACH SIDE
- FOUR (4) WHELEN ION RED LED - CHROME TWO (2) EACH SIDE

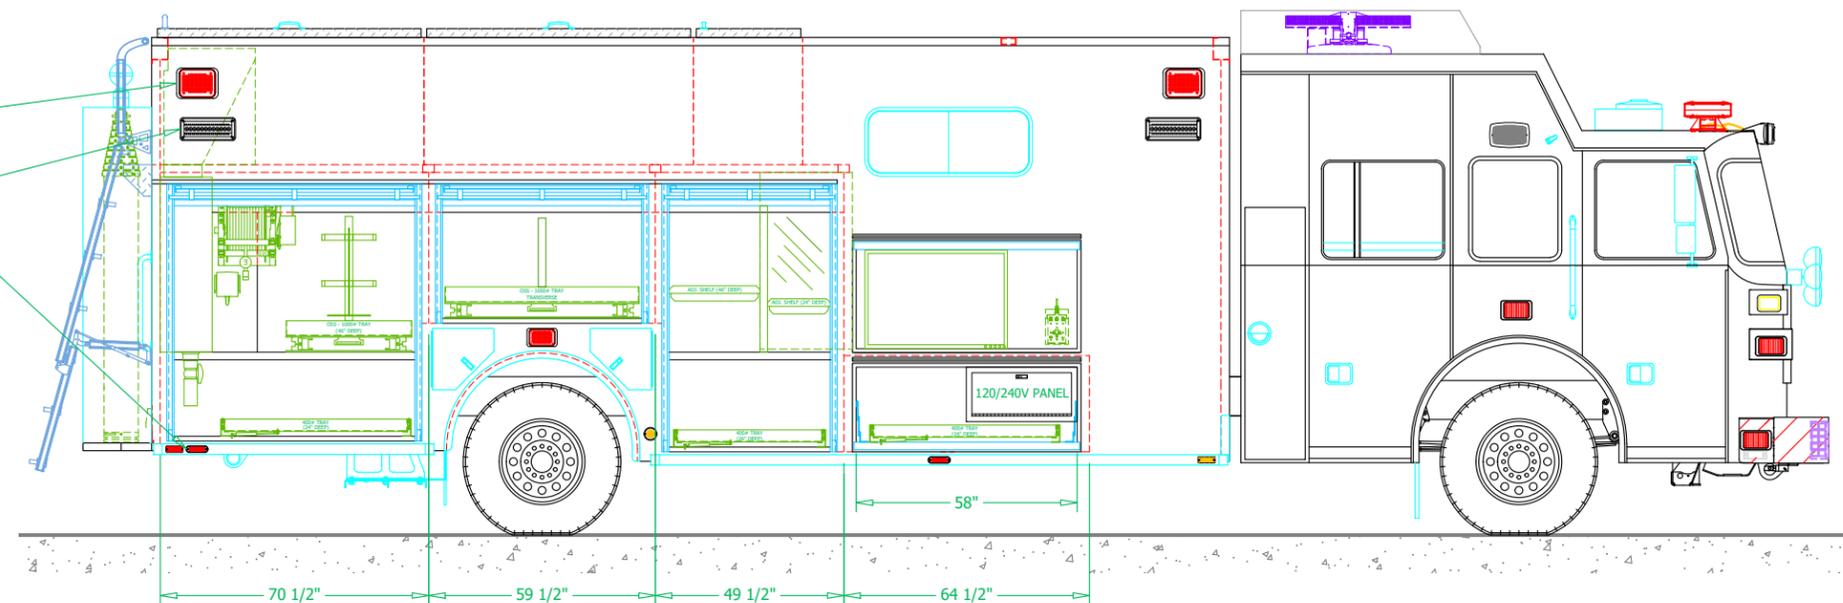

THIS PRINT IS PROVIDED ON A RESTRICTED BASIS AND IS NOT TO BE USED IN ANY WAY DETRIMENTAL TO THE INTEREST OF SUTPHEN CORPORATION.



SUTPHEN CORPORATION
FIRE APPARATUS SINCE 1890
7000 COLUMBUS-MARYSVILLE ROAD
AMLIN, OHIO 43002


**LEXINGTON COUNTY
FIRE SERVICE**

BODY SIZE: 24' BODY	UNIT TYPE: HAZ-MAT
BODY MATERIAL: 3/16" ALUMINUM	TRUCK NO: SVI #1209
CHASSIS TYPE: SUTPHEN	WHEELBASE: 256.5"
56"	CAB TO AXLE: 183.5"
20" RR	OVERALL LENGTH (OAL): 458.5"
FOUR DOOR	OVERALL WIDTH (OAW): 100"
	OVERALL HEIGHT (OAH): 138"


DRAWN BY: KP DATE: March 20, 2023 SCALE: 1/4" = 1'-0"
DRAWING NO: LexingtonCounty SC hz24 AsBuilt SHEET 2 OF 3

REVISIONS			
REV	DESCRIPTION	DATE	BY


PLAN VIEW
CROSS-SECTION

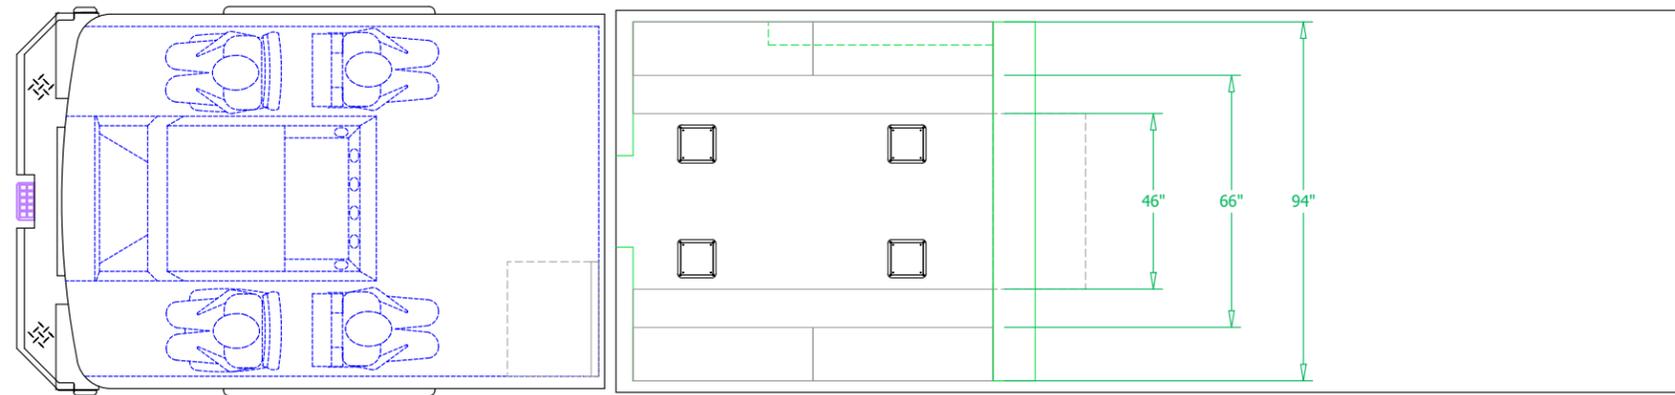


CURBSIDE INTERIOR
CROSS-SECTION

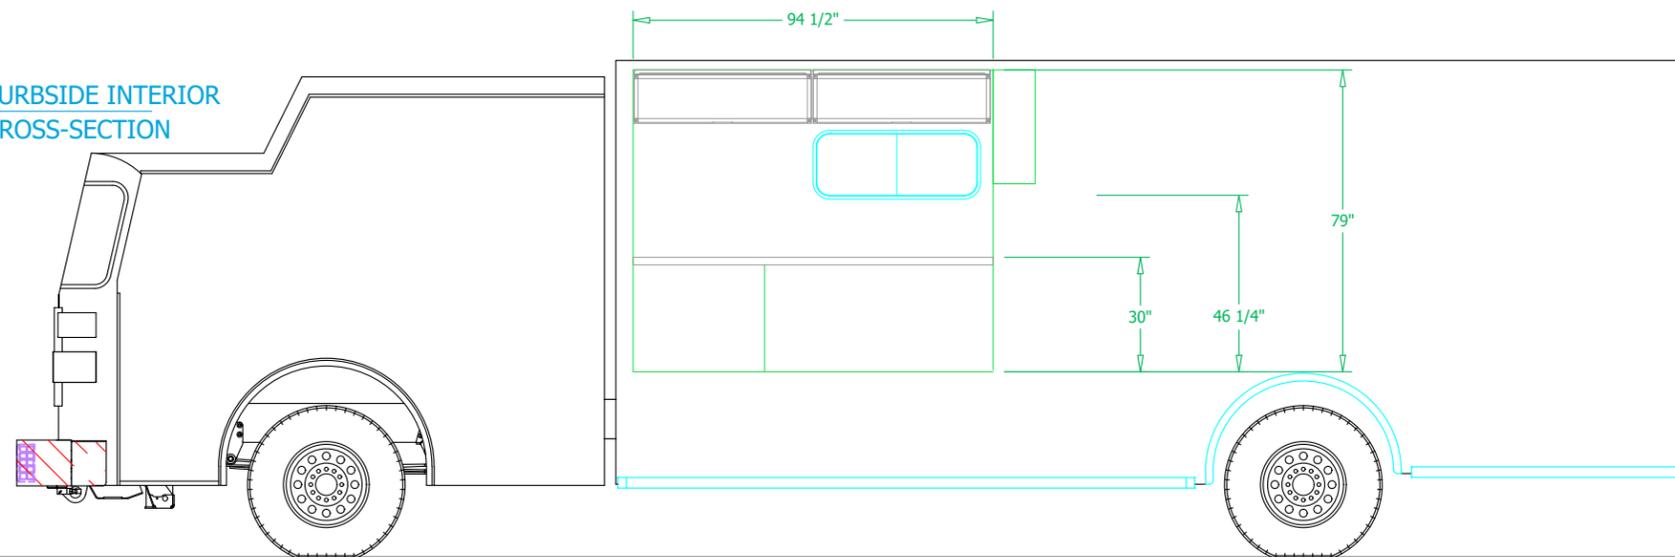

REAR VIEW
CROSS-SECTION

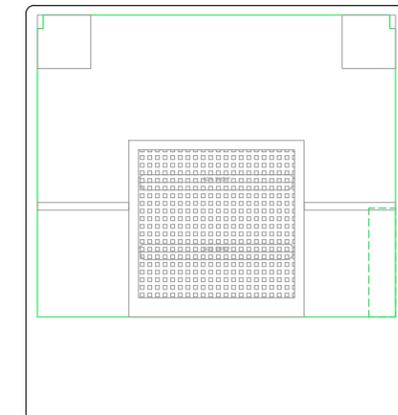

STREETSIDE INTERIOR
CROSS-SECTION

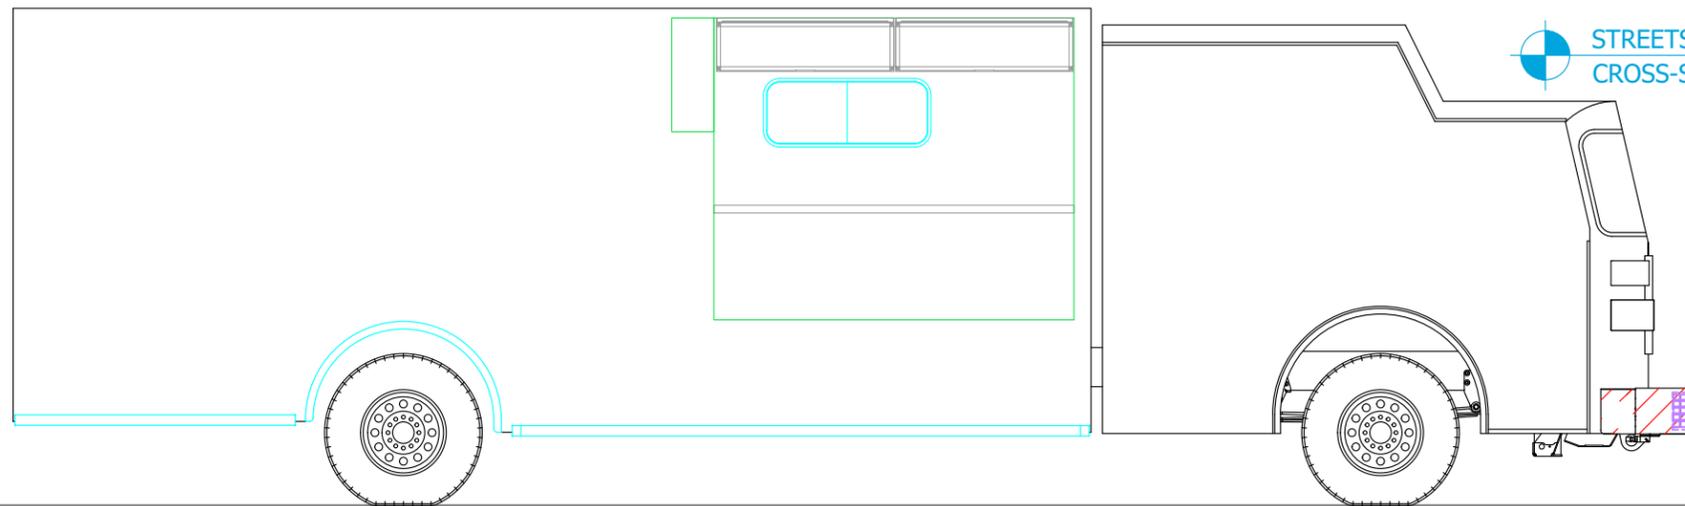

THIS PRINT IS PROVIDED ON A RESTRICTED BASIS AND IS NOT TO BE USED IN ANY WAY DETRIMENTAL TO THE INTEREST OF SUTPHEN CORPORATION.

SUTPHEN CORPORATION
FIRE APPARATUS SINCE 1890
7000 COLUMBUS-MARYSVILLE ROAD
AMLIN, OHIO 43002

**LEXINGTON COUNTY
FIRE SERVICE**

BODY SIZE: 24' BODY	UNIT TYPE: HAZ-MAT
BODY MATERIAL: 3/16" ALUMINUM	TRUCK NO: SVI #1209
CHASSIS TYPE: SUTPHEN	WHEELBASE: 256.5"
56"	CAB TO AXLE: 183.5"
20" RR	OVERALL LENGTH (OAL): 458.5"
FOUR DOOR	OVERALL WIDTH (OAW): 100"
	OVERALL HEIGHT (OAH): 138"

DRAWN BY: KP DATE: March 20, 2023 SCALE: 1/4" = 1'-0"

DRAWING NO: LexingtonCounty SC h224 AsBuilt SHEET 3 OF 3